

Date: Wednesday, 1/18/2006 4:05:15 PM
 User: Kim Johnston

Process Sheet

Customer : CU-DAR001 Dart Helicopters Services	Drawing Name : BRACKET ASSEMBLY
Job Number : 25557A	
Estimate Number : 10278	
P.O. Number : N/A	Part Number : D3121141
This Issue : 1/18/2006 S.O. No. : N/A	Drawing Number : D3121 REV C2
Prsht Rev. : NC	Project Number : N/A
First Issue : N/A Type : MACHINED PARTS	Drawing Revision : C2
Previous Run : 25556A	Material : N/A
Written By : <u>SEE COMMENT BELOW</u>	Due Date : 2/15/2006
Checked & Approved By : <u>SEE ABOVE DATE & USER</u>	Qty: 12 Um: Each
Comment : Est Rev: Pick: A 04.02.18 New issue KJ/DS	

Additional Product

Job Number:



Seq. #:	Machine Or Operation:	Description :
----------------	------------------------------	----------------------

1.0	M174B1000X02000	17-4 SS Bar
-----	-----------------	-------------



Comment: Qty.: 0.5775 f(s)/Unit Total : 6.9300 f(s)
 Material: 17-4 SS Bar per AMS 5604/5643
 (M17-4-B1.000x02.000)
 Identify for D3121-111
 Batch: M19712

M8 06/02/10

2.0	BAND SAW	BAND SAW
-----	----------	----------



Comment: BAND SAW
 Cut blanks: (1.000" x 2.000") 6.600" long

M8 06/02/10

12 + 1

3.0	HAAS1	HAAS CNC VERTICAL MACHINING #1
-----	-------	--------------------------------

**Comment:** HAAS CNC VERTICAL MACHINING #1

1-Machine D3121-111 as per Folio FA361 and Dwg D3121 Identify as D3121-111

SD/M8 06/02/10

12

2-Deburr ✓

3-Scribe batch number ✓

P10

4.0	QC2	INSPECT PARTS AS THEY COME OFF MACHINE
-----	-----	--

**Comment:** INSPECT PARTS AS THEY COME OFF MACHINE





SD/M8 06/02/10

12

W/O:		WORK ORDER CHANGES					
DATE	STEP	PROCEDURE CHANGE	By	Date	Qty	Approval Chief Eng / Prod Mgr	Approval QC Inspector

Part No: _____ PAR #: _____ Fault Category: _____ NCR: Yes ☐ No ☒ DQA: ☒ Date: 06/02/27

QA: N/C Closed: _____ Date: _____

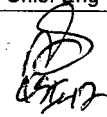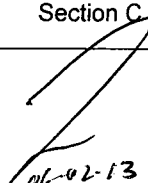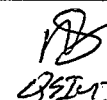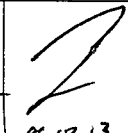NCR:		WORK ORDER NON-CONFORMANCE (NCR)						
DATE	STEP	Description of NC Section A	Corrective Action Section B			Verification Section C	Approval Chief Eng	Approval QC Inspector
			Initial Chief Eng	Action Description Chief Eng	Sign & Date			
06.02.13	3.1	-part flew out of vice while machining. Damage on back side. 035deng		Scrap and close trap. + Replace	SD 06.02.13	 06-02-13	 06-02-13	 06-02-13

NOTE: Date & initial all entries

Date: Wednesday, 1/18/2006 4:05:15 PM
User: Kim Johnston

Process Sheet

Customer: CU-DAR001 Dart Helicopters Services

Drawing Name: BRACKET ASSEMBLY

Job Number: 25557A

Part Number: D3121141

Job Number:



Seq. #:

Machine Or Operation:

Description :

5.0

QC8

SECOND CHECK



Comment: SECOND CHECK

SC 06-02-13 12

6.0

D312121

Bolt



Comment: Qty.: 1.0000 Each(s)/Unit Total: 12.0000 Each(s)

Pick:

Qty Part Number

Description Batch

1 D3121-21

Bolt

B25456

x12

En 06/02/24 12

7.0

D3121241

Bearing Assembly



Comment: Qty.: 1.0000 Each(s)/Unit Total: 12.0000 Each(s)

Pick:

Qty Part Number

Description Batch

1 D3121-241 Bearing Ass

B25225 x2

B25477 x10

En 06/02/24 x12

8.0

SMALL FAB 1

SMALL & MEDIUM FAB RESOURCE 1



Comment: SMALL & MEDIUM FAB RESOURCE 1
Assemble D3121-141 as per Dwg D3121.

En 06/02/24 x12

9.0

QC5

INSPECT WORK TO CURRENT STEP



Comment: INSPECT WORK TO CURRENT STEP

MS 06/02/24 x12

10.0

PACKAGING 1

PACKAGING RESOURCE #1



Comment: PACKAGING RESOURCE #1

Identify and Stock

Location:

st 408

06/02/27 (12)

11.0

DC

DOCUMENT CONTROL



Comment: DOCUMENT CONTROL

Inspection Level 21

06/02/27 (12)

Job Completion



06/02/27

W/O:		WORK ORDER CHANGES					
DATE	STEP	PROCEDURE CHANGE	By	Date	Qty	Approval Chief Eng / Prod Mgr	Approval QC Inspector

Part No: _____ PAR #: _____ Fault Category: _____ NCR: Yes No DQA: _____ Date: _____

QA: N/C Closed: _____ Date: _____

NCR:		WORK ORDER NON-CONFORMANCE (NCR)						
DATE	STEP	Description of NC Section A	Corrective Action Section B			Verification Section C	Approval Chief Eng	Approval QC Inspector
			Initial Chief Eng	Action Description Chief Eng	Sign & Date			

NOTE: Date & initial all entries

DART AEROSPACE LTD		Work Order:	25557A
Description: Bracket		Part Number:	D3121-111
Inspection Dwg: D3121 Rev: B1		Page 1 of 1	

FIRST ARTICLE INSPECTION CHECKLIST

☒ First Article ☐ Prototype

Drawing Dimension	Tolerance	Actual Dimension	Accept	Reject	Method of Inspection	Comments
6.18	+/-0.030	6.180	✓			
5.90	+/-0.030	5.912	✓			
5.89	+/-0.030	5.895	✓			
0.019	+/-0.010					
0.320	+/-0.010					
0.573	+/-0.010	.580	✓			
2.14	+/-0.030	2.14	✓			
0.950	+/-0.010	.952	✓			
0.664	+/-0.010	.664	✓			
1.96	+/-0.030	1.96	✓			
0.98	+/-0.030	.98	✓			
0.280	+/-0.010	.286	✓			
3.330	+/-0.010	3.332	✓			
3.630	+/-0.010	3.635	✓			
4.580	+/-0.010	4.580	✓			
Ø0.392	+0.002/-0.000	.393	✓			
0.750	+/-0.010	.750	✓			
R0.25	+/-0.030	R.25	✓			
0.130	+/-0.010	.128	✓			
0.400	+/-0.010	.392	✓			
0.201	+/-0.010	.198	✓			
0.580	+/-0.010	.576	✓			
0.381	+/-0.010	.384	✓			
0.032	+/-0.010	.026	✓			


Measured by:	MS	Audited by:	mf	Prototype Approval:	N/A
Date:	06/02/10	Date:	06/02/10	Date:	N/A

Rev	Date	Change	Revised by	Approved
A	04.01.12	New Issue	KJ/RF	




DESIGN #	DRAWN BY UP	DART AEROSPACE LTD HAWKESBURY, ONTARIO, CANADA	
CHECKED #	APPROVED #	DRAWING NO. D3121	REV. C SHEET 1 OF 10
DATE 04.02.17		TITLE BRACKET ASSEMBLY	SCALE 1:2
A	02.04.15	NEW ISSUE	
B	03.01.16	ADD RIDGES; ADD MAT'L PROP; FIX P/N ADD -141/-143/-144/-145/-146	
C	04.02.17	ADD CLEARANCE; USE -241 BEARING	
C1	04.03.26	3.97 WAS 4.00; 6.11 WAS 6.14	
C2	04.04.26	0.230 WAS 0.238	


RELEASED
04-03-01

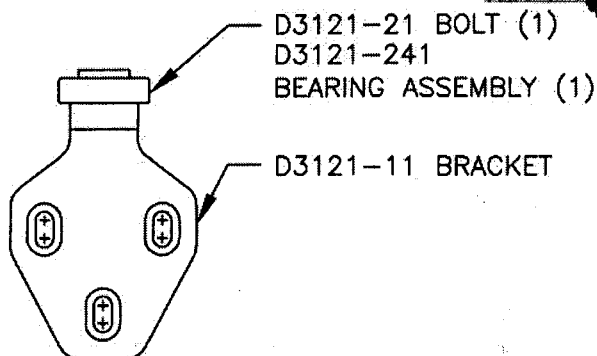

D3121-041 BRACKET ASSEMBLY
(REPLACES PREMIER P/N B30-23000-33)

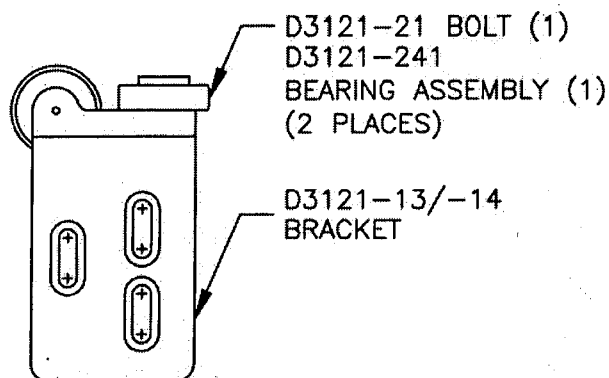

D3121-043 (SHOWN) / D3121-044 (OPPOSITE) BRACKET ASSEMBLY
(REPLACES PREMIER P/N B30-23000-37/-38)

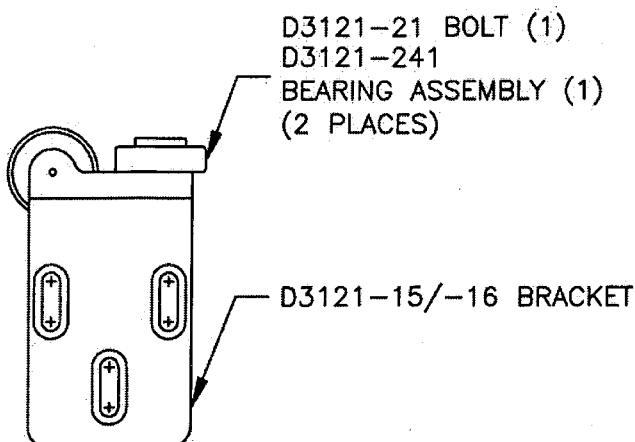

D3121-045 (SHOWN) / D3121-046 (OPPOSITE) BRACKET ASSEMBLY
(REPLACES PREMIER P/N B30-23000-35/-36)


RETURN TO
UNCONTROLLED COPY
SUBJECT TO
WITHOUT
WORK ORDER
NO. 25557A

Copyright © 2002 by DART AEROSPACE LTD

THIS DOCUMENT IS PRIVATE AND CONFIDENTIAL AND IS SUPPLIED ON THE EXPRESS CONDITION THAT IT IS NOT TO BE USED FOR ANY PURPOSE OR COPIED OR COMMUNICATED TO ANY OTHER PERSON WITHOUT WRITTEN PERMISSION FROM DART AEROSPACE LTD.




DESIGN	DRAWN BY	DART AEROSPACE LTD HAWKESBURY, ONTARIO, CANADA	
CHECKED	APPROVED	DRAWING NO. D3121	REV. C SHEET 2 OF 10
DATE 04.02.17		TITLE BRACKET ASSEMBLY	SCALE 1:2

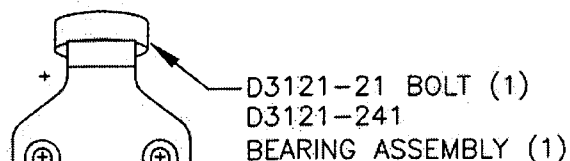


D3121-111 BRACKET

D3121-141 BRACKET ASSEMBLY
(REPLACES PREMIER P/N B30-23001-01)

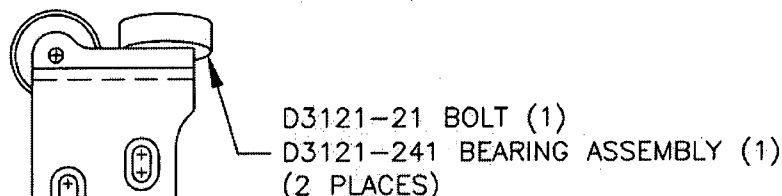

D3121-113/-114 BRACKET

D3121-143 (SHOWN) / D3121-144 (OPPOSITE)
BRACKET ASSEMBLY
(REPLACES PREMIER P/N B30-23000-03/-04)

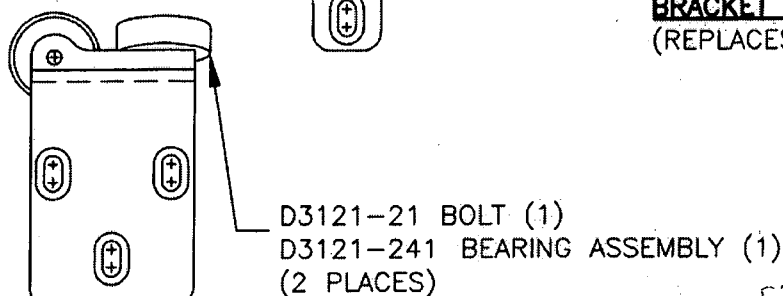

D3121-115/-116 BRACKET

D3121-145 (SHOWN) / D3121-146 (OPPOSITE)
BRACKET ASSEMBLY
(REPLACES PREMIER P/N B30-23000-05/-06)

SHOP COPY
CONTROL
INTER
SHEET 2 OF 10
DATE 04.03.01

WORK ORDER
NO 25557A

RELEASED
04.03.01

Copyright © 2002 by DART AEROSPACE LTD



THIS DOCUMENT IS PRIVATE AND CONFIDENTIAL AND IS SUPPLIED ON THE EXPRESS CONDITION THAT IT IS NOT TO BE USED FOR ANY PURPOSE OR COPIED OR COMMUNICATED TO ANY OTHER PERSON WITHOUT WRITTEN PERMISSION FROM DART AEROSPACE LTD.



DESIGN #	DRAWN BY CP	DART AEROSPACE LTD HAWKESBURY, ONTARIO, CANADA	
CHECKED #	APPROVED #	DRAWING NO. D3121	REV. C SHEET 3 OF 10
DATE 04.02.17		TITLE BRACKET ASSEMBLY	SCALE 1:1


RELEASED
04.03.01 #

DETAIL A:
SLOT DETAIL
SCALE 2:1
VIEW ROTATED

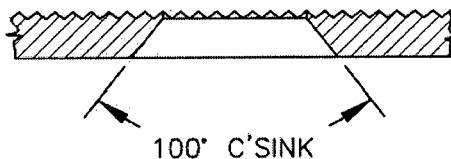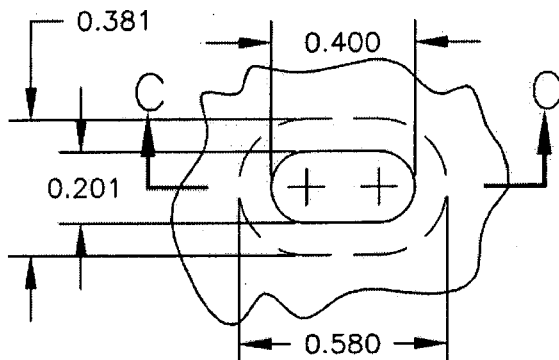

SECTION
C-C

DETAIL B:
RIDGE DETAIL
PARTIAL SECTION
SCALE 1:20

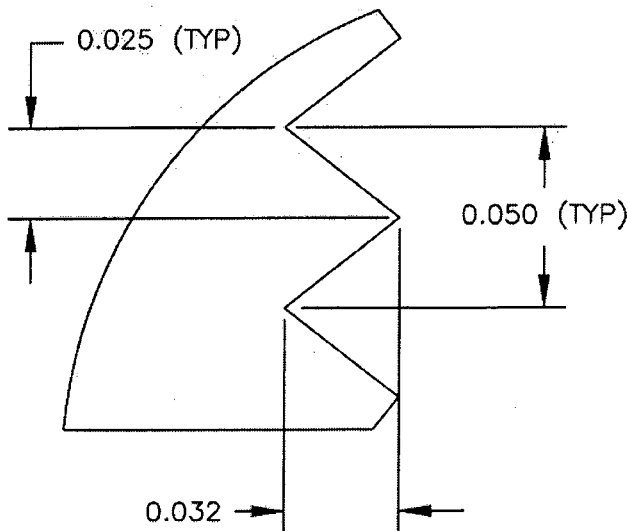

SHOP COPY
RETURN TO
ENGINEERING
UNCONTROLLED COPY
SUBJECT TO CHANGE
WITHOUT NOTICE


Copyright © 2002 by DART AEROSPACE LTD

THIS DOCUMENT IS PRIVATE AND CONFIDENTIAL AND IS SUPPLIED ON THE EXPRESS CONDITION THAT IT IS NOT TO BE USED FOR ANY PURPOSE OR COPIED OR COMMUNICATED TO ANY OTHER PERSON WITHOUT WRITTEN PERMISSION FROM DART AEROSPACE LTD.

WORK ORDER
NO. 25567A

DART

DESIGN	DRAWN BY	DART AEROSPACE LTD HAWKESBURY, ONTARIO, CANADA	
CHECKED	APPROVED	DRAWING NO. D3121	REV. C SHEET 4 OF 10
DATE 04.02.17		TITLE BRACKET ASSEMBLY	SCALE 1:1

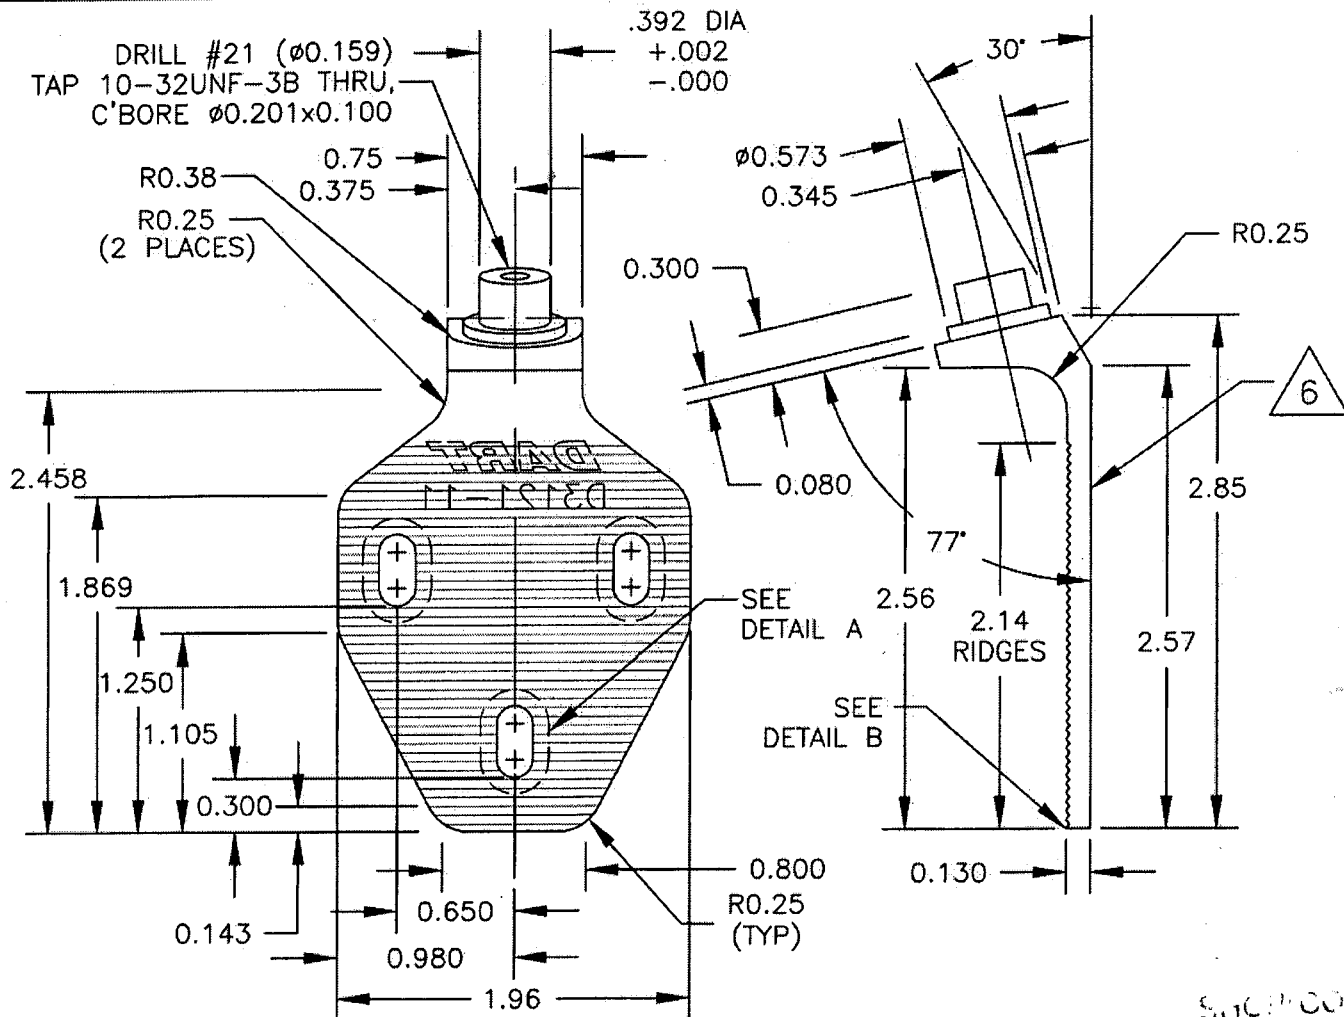**D3121-11 BRACKET**

- 1) MATERIAL: 17-4 SS PER AMS 5604/5643 (REF DART SPEC. M17-4-B)
MIN ULTIMATE TENSILE = 150 ksi
MIN YIELD TENSILE = 100 ksi
- 2) TOLERANCES ARE PER DART QSI 018 UNLESS OTHERWISE NOTED
- 3) ALL DIMENSIONS ARE IN INCHES
- 4) BREAK ALL SHARP EDGES 0.005 TO 0.015
- 5) ENGRAVE DART P/N & LOGO AS SHOWN
- 6) HOLE IN SPIGOT TO BE CONCENTRIC WITHIN 0.005

SHOWN COPY
RETURN TO
ENGINEERING
CONTROL
SUBJECT TO
WITHOUT NOTICE
WORK ORDER
NO. 25557A


RELEASED
04.03.01

Copyright © 2004 by DART AEROSPACE LTD

THIS DOCUMENT IS PRIVATE AND CONFIDENTIAL AND IS SUPPLIED ON THE EXPRESS CONDITION THAT IT IS NOT TO BE USED FOR ANY PURPOSE OR COPIED OR COMMUNICATED TO ANY OTHER PERSON WITHOUT WRITTEN PERMISSION FROM DART AEROSPACE LTD.

DART

DESIGN	DRAWN BY	DART AEROSPACE LTD HAWKESBURY, ONTARIO, CANADA	
CHECKED	APPROVED	DRAWING NO. D3121	REV. C SHEET 5 OF 10
DATE 04.02.18	TITLE BRACKET ASSEMBLY		SCALE 1:2

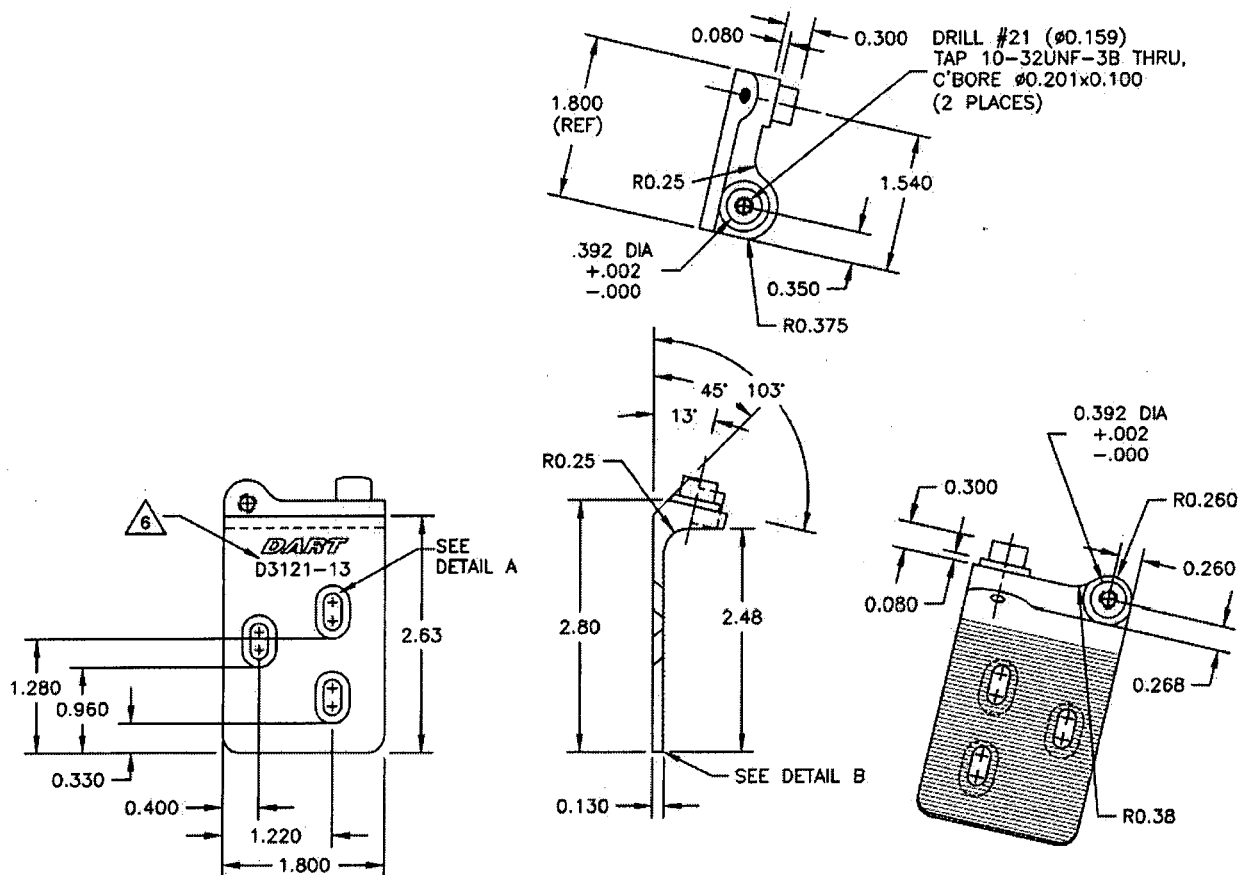

D3121-13 BRACKET (SHOWN)
D3121-14 BRACKET (OPPOSITE)

- 1) MATERIAL: 17-4 SS PER AMS 5604/5643 (REF DART SPEC. M17-4-B)
MIN ULTIMATE TENSILE STRENGTH = 150 ksi
MIN YIELD TENSILE STRENGTH = 100 ksi
- 2) TOLERANCES ARE PER DART QSI 018 UNLESS OTHERWISE NOTED
- 3) ALL DIMENSIONS ARE IN INCHES
- 4) BREAK ALL SHARP EDGES 0.005 TO 0.015
- 5) ENGRAVE DART P/N & LOGO AS SHOWN
- 6) HOLE IN SPIGOT TO BE CONCENTRIC WITHIN 0.005

SHOP COPY
RETURN TO
ENGINEERING
UNCONTROLLED COPY
SUBJECT TO ALTERATION
WITHOUT NOTICE

WORK ORDER
NO. 25557A


RELEASED
04.03.01

Copyright © 2002 by DART AEROSPACE LTD

THIS DOCUMENT IS PRIVATE AND CONFIDENTIAL AND IS SUPPLIED ON THE EXPRESS CONDITION THAT IT IS NOT TO BE USED FOR ANY PURPOSE OR COPIED OR COMMUNICATED TO ANY OTHER PERSON WITHOUT WRITTEN PERMISSION FROM DART AEROSPACE LTD.



DESIGN #	DRAWN BY UP	DART AEROSPACE LTD HAWKESBURY, ONTARIO, CANADA	
CHECKED #	APPROVED #	DRAWING NO. D3121	REV. C SHEET 6 OF 10
DATE 04.02.18		TITLE BRACKET ASSEMBLY	SCALE 1:2

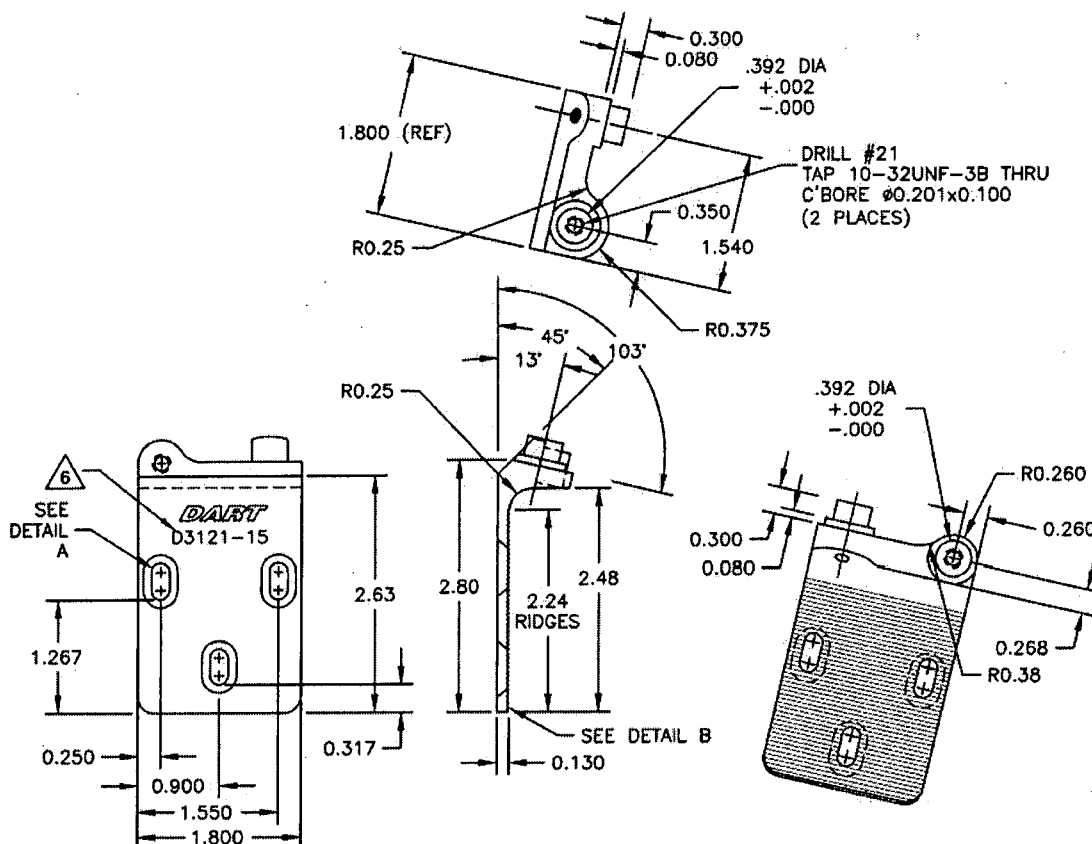

D3121-15 BRACKET (SHOWN)

D3121-16 BRACKET (OPPOSITE)

- 1) MATERIAL: 17-4 SS PER AMS 5604/5643 (REF DART SPEC. M17-4-B)
MIN ULTIMATE TENSILE = 150 ksi
MIN YIELD TENSILE = 100 ksi
- 2) TOLERANCES ARE PER DART QSI 018 UNLESS OTHERWISE NOTED
- 3) ALL DIMENSIONS ARE IN INCHES
- 4) BREAK ALL SHARP EDGES 0.005 TO 0.015
- 5) ENGRAVE DART P/N AND LOGO AS SHOWN
- 6) HOLE IN SPIGOT TO BE CONCENTRIC WITHIN 0.005

STOP! COPY
RETURN TO
ENGINEERING

UNCONTROLLED COPY
SUBJECT TO AMENDMENT
WITHOUT NOTICE

WORK ORDER

NO. 25557A


RELEASED
04-03-01

Copyright © 2002 by DART AEROSPACE LTD

THIS DOCUMENT IS PRIVATE AND CONFIDENTIAL AND IS SUPPLIED ON THE EXPRESS CONDITION THAT IT IS NOT TO BE USED FOR ANY PURPOSE OR COPIED OR COMMUNICATED TO ANY OTHER PERSON WITHOUT WRITTEN PERMISSION FROM DART AEROSPACE LTD.



DESIGN #	DRAWN BY #	DART AEROSPACE LTD HAWKESBURY, ONTARIO, CANADA	
CHECKED #	APPROVED #	DRAWING NO. D3121	REV. C SHEET 7 OF 10
DATE 04.02.18		TITLE BRACKET ASSEMBLY	SCALE 1:2

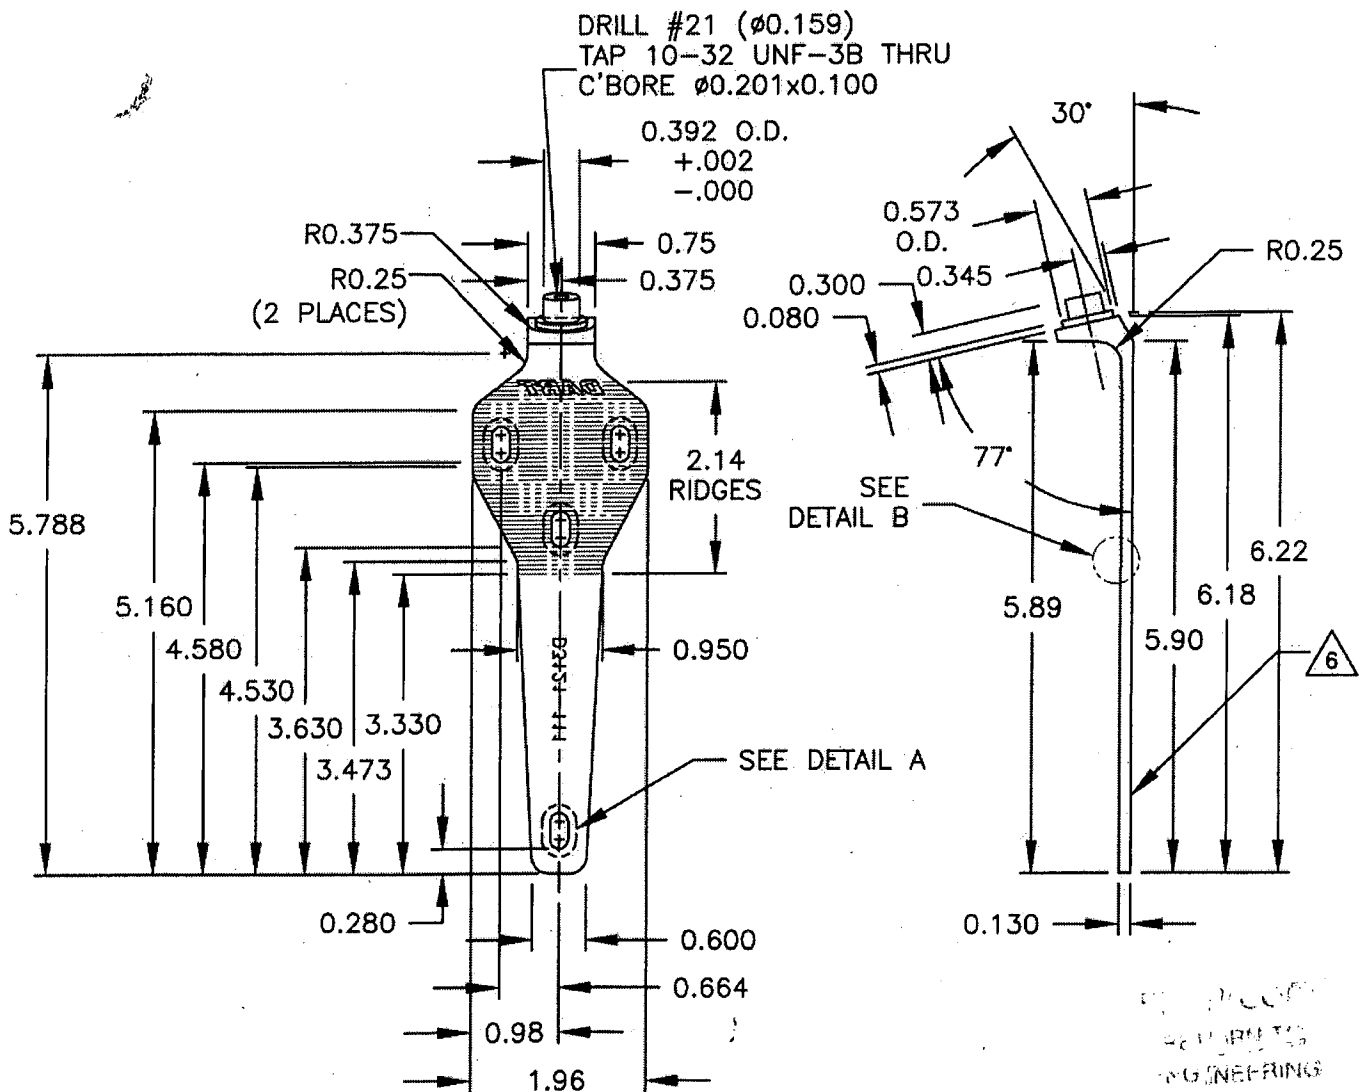

D3121-111 BRACKET

- 1) REPLACES PREMIER P/N B32-23001-11
- 2) MATERIAL: 17-4 SS PER AMS 5604/5643 (REF DART SPEC. M17-4-B)
MIN ULTIMATE TENSILE = 150 ksi
MIN YIELD TENSILE = 100 ksi
- 3) TOLERANCES ARE PER DART QSI 018 UNLESS OTHERWISE NOTED
- 4) ALL DIMENSIONS ARE IN INCHES
- 5) BREAK ALL SHARP EDGES 0.005 TO 0.015
- 6) ENGRAVE DART P/N & LOGO IN AREAS SHOWN
- 7) HOLE IN SPIGOT TO BE CONCENTRIC WITHIN 0.005

CONTROLLED COPY
SUBJECT TO AMENDMENT
WITHOUT NOTICE

WORK ORDER

NO. 25557 A

RELEASED
04.03.01


Copyright © 2002 by DART AEROSPACE LTD

THIS DOCUMENT IS PRIVATE AND CONFIDENTIAL AND IS SUPPLIED ON THE EXPRESS CONDITION THAT IT IS NOT TO BE USED FOR ANY PURPOSE OR COPIED OR COMMUNICATED TO ANY OTHER PERSON WITHOUT WRITTEN PERMISSION FROM DART AEROSPACE LTD.



DESIGN <i>[Signature]</i>	DRAWN BY <i>[Signature]</i>	DART AEROSPACE LTD HAWKESBURY, ONTARIO, CANADA	
CHECKED <i>[Signature]</i>	APPROVED <i>[Signature]</i>	DRAWING NO. D3121	REV. C SHEET 8 OF 10
DATE 04.02.18	TITLE BRACKET ASSEMBLY		SCALE 1:2

RECEIVED
04.03.01 *[Signature]*

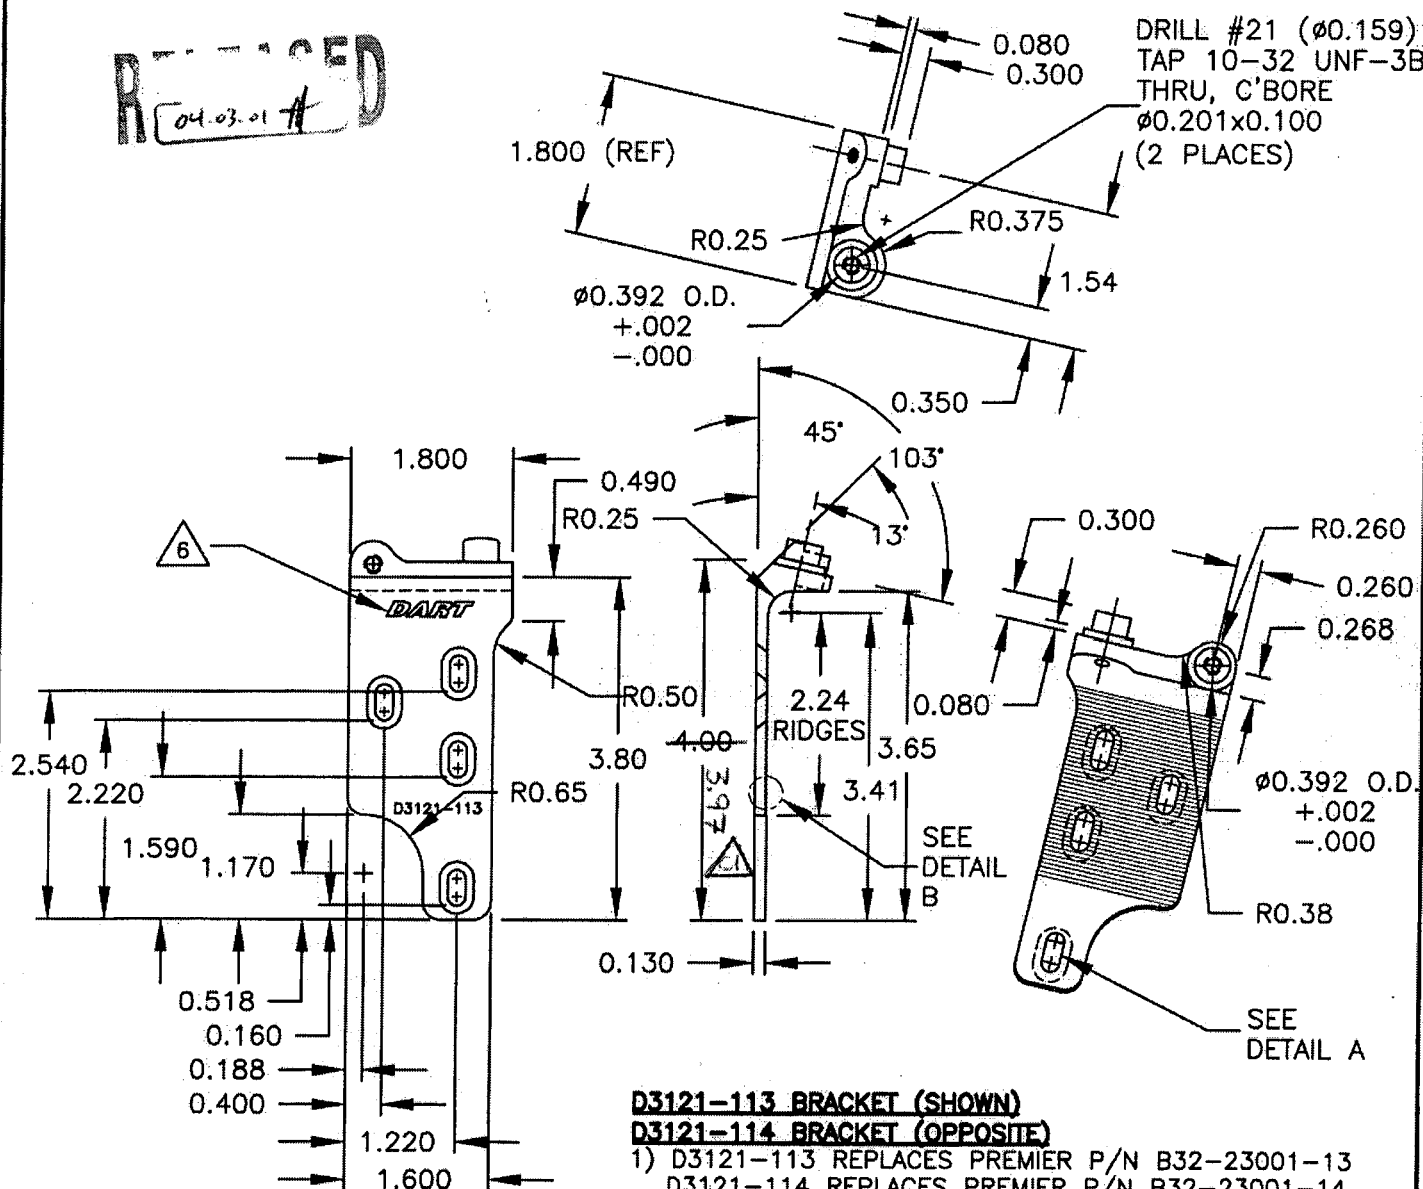

D3121-113 BRACKET (SHOWN)

D3121-114 BRACKET (OPPOSITE)

- 1) D3121-113 REPLACES PREMIER P/N B32-23001-13
D3121-114 REPLACES PREMIER P/N B32-23001-14

- 2) MATERIAL: 17-4 SS PER AMS 5604/5643

(REF DART SPEC. M17-4-B)

MIN ULTIMATE TENSILE STRENGTH = 150 ksi

MIN YIELD TENSILE STRENGTH = 100 ksi

- 3) TOLERANCES ARE PER DART QSI 018 UNLESS OTHERWISE NOTED

- 4) ALL DIMENSIONS ARE IN INCHES

- 5) BREAK ALL SHARP EDGES 0.005 TO 0.015

- 6) ENGRAVE DART P/N & LOGO IN AREAS SHOWN

- 7) HOLE IN SPIGOT TO BE CONCENTRIC WITHIN 0.005

Copyright © 2002 by DART AEROSPACE LTD


THIS DOCUMENT IS PRIVATE AND CONFIDENTIAL AND IS SUPPLIED ON THE EXPRESS CONDITION THAT IT IS NOT TO BE USED FOR ANY PURPOSE OR COPIED OR COMMUNICATED TO ANY OTHER PERSON WITHOUT WRITTEN PERMISSION FROM DART AEROSPACE LTD.

25557A



DESIGN #	DRAWN BY #	DART AEROSPACE LTD HAWKESBURY, ONTARIO, CANADA	
CHECKED #	APPROVED #	DRAWING NO. D3121	REV. C SHEET 9 OF 10
DATE 04.02.18		TITLE BRACKET ASSEMBLY	SCALE 1:2

RELEASED
04.03.01

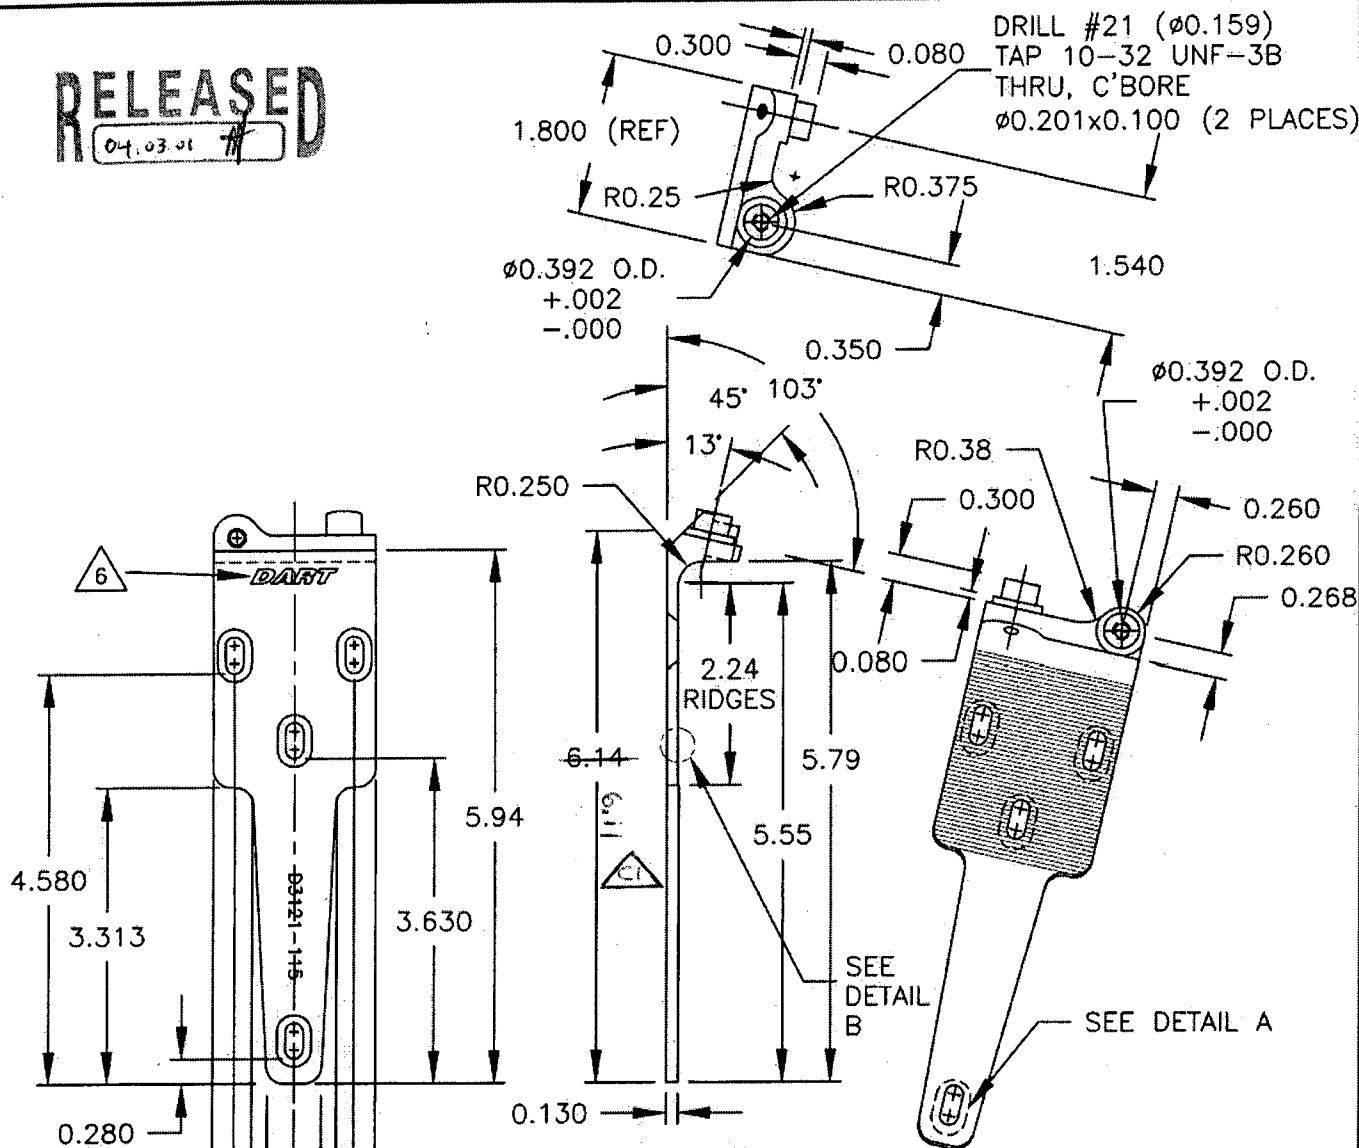

D3121-115 BRACKET (SHOWN)

D3121-116 BRACKET (OPPOSITE)

- 1) D3121-115 REPLACES PREMIER P/N B32-23001-15
D3121-116 REPLACES PREMIER P/N B32-23001-16
- 2) MATERIAL: 17-4 SS PER AMS 5604/5643
(REF DART SPEC. M17-4-B)
MIN ULTIMATE TENSILE STRENGTH = 150 ksi
MIN YIELD TENSILE STRENGTH = 100 ksi
- 3) TOLERANCES ARE PER DART QSI 018 UNLESS OTHERWISE NOTED
- 4) ALL DIMENSIONS ARE IN INCHES
- 5) BREAK ALL SHARP EDGES 0.005 TO 0.015
- 6) ENGRAVE DART P/N & LOGO IN AREAS SHOWN
- 7) HOLE IN SPIGOT TO BE CONCENTRIC WITHIN 0.005

Copyright © 2002 by DART AEROSPACE LTD

THIS DOCUMENT IS PRIVATE AND CONFIDENTIAL AND IS SUPPLIED ON THE EXPRESS CONDITION THAT IT IS NOT TO BE USED FOR ANY PURPOSE OR COPIED OR COMMUNICATED TO ANY OTHER PERSON WITHOUT WRITTEN PERMISSION FROM DART AEROSPACE LTD.

COPY
ENGINEERING
REVISED COPY
AMENDMENT


OUT NOTICE

ORDER

25557A




DESIGN	DRAWN BY	DART AEROSPACE LTD HAWKESBURY, ONTARIO, CANADA	
CHECKED	APPROVED	DRAWING NO. D3121	REV. C SHEET 10 OF 10
DATE 04.02.17		TITLE BRACKET ASSEMBLY	SCALE 1:1

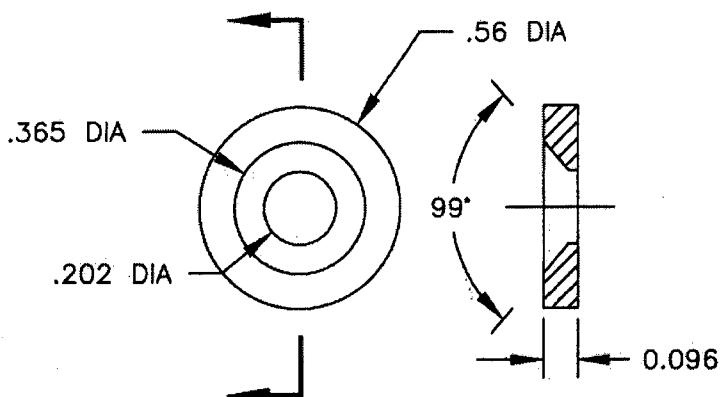


D3121-17 WASHER (SCALE 2:1)

- 1) REPLACES PREMIER P/N B32-23001-17
- 2) MATERIAL: AISI 303 SS ROUND BAR, ANNEALED (REF DART SPEC. M303R)
- 3) TOLERANCES ARE PER DART QSI 018 UNLESS OTHERWISE NOTED
- 4) ALL DIMENSIONS ARE IN INCHES
- 5) BREAK ALL SHARP EDGES 0.005 TO 0.015

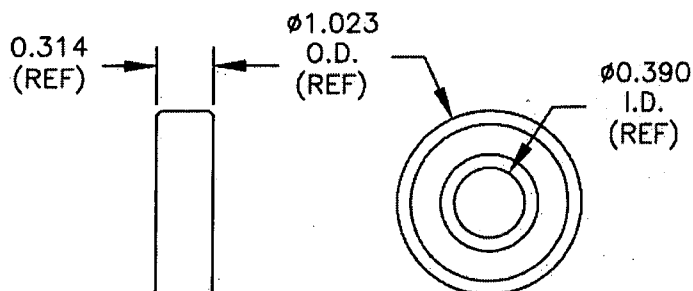


D3121-19 BEARING (SCALE 1:1)

- 1) POSSIBLE SUPPLIER: KING BEARING P/N 6000-2ZJ/EM FAFNIR P/N 9100KDD
- 2) ALL DIMENSIONS ARE IN INCHES

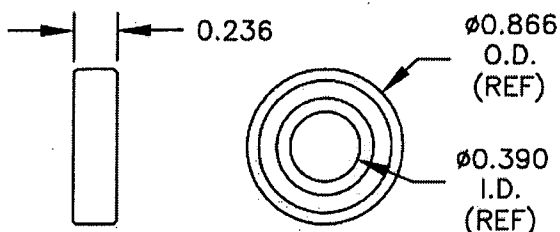


D3121-23 BEARING (SCALE 1:1)

- 1) POSSIBLE SUPPLIER: SKF P/N 61900-2Z OR KML P/N 6900-2Z
- 2) ALL DIMENSIONS ARE IN INCHES

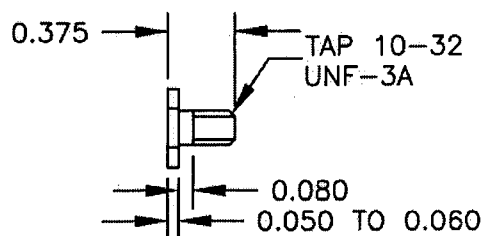

D3121-21 BOLT (SCALE 1:1)


- 1) MATERIAL: AISI 303 SS HEX, ANNEALED (REF DART SPEC. M303H0.500)
- 2) FINISH: NONE
- 3) TOLERANCES ARE PER DART QSI 018 UNLESS OTHERWISE NOTED
- 4) ALL DIMENSIONS ARE IN INCHES
- 5) BREAK ALL SHARP EDGES 0.005 TO 0.015

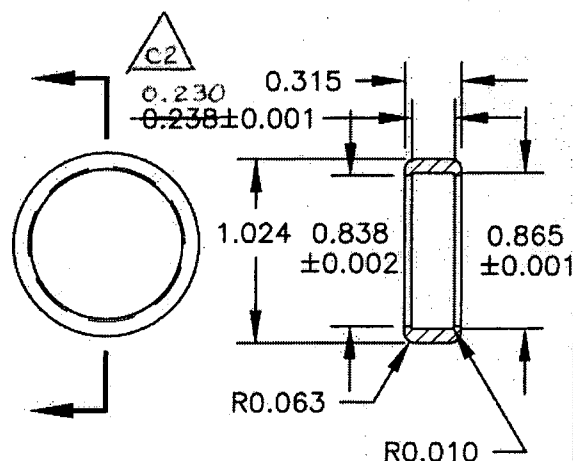

D3121-25 CAP (SCALE 1:1)

- 1) MATERIAL: DELRIN ROD, 1.25 (REF DART SPEC. M-DELRIN-R1.250)
- 2) TOLERANCES ARE PER DART QSI 018 UNLESS OTHERWISE NOTED
- 3) ALL DIMENSIONS ARE IN INCHES

RELEASED
04.03.01

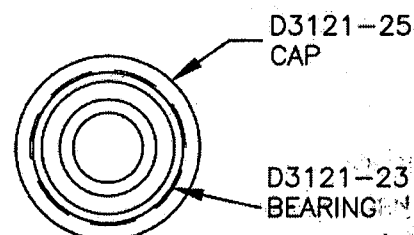

D3121-241 BEARING ASSEMBLY (SCALE 1:1)